



As Built

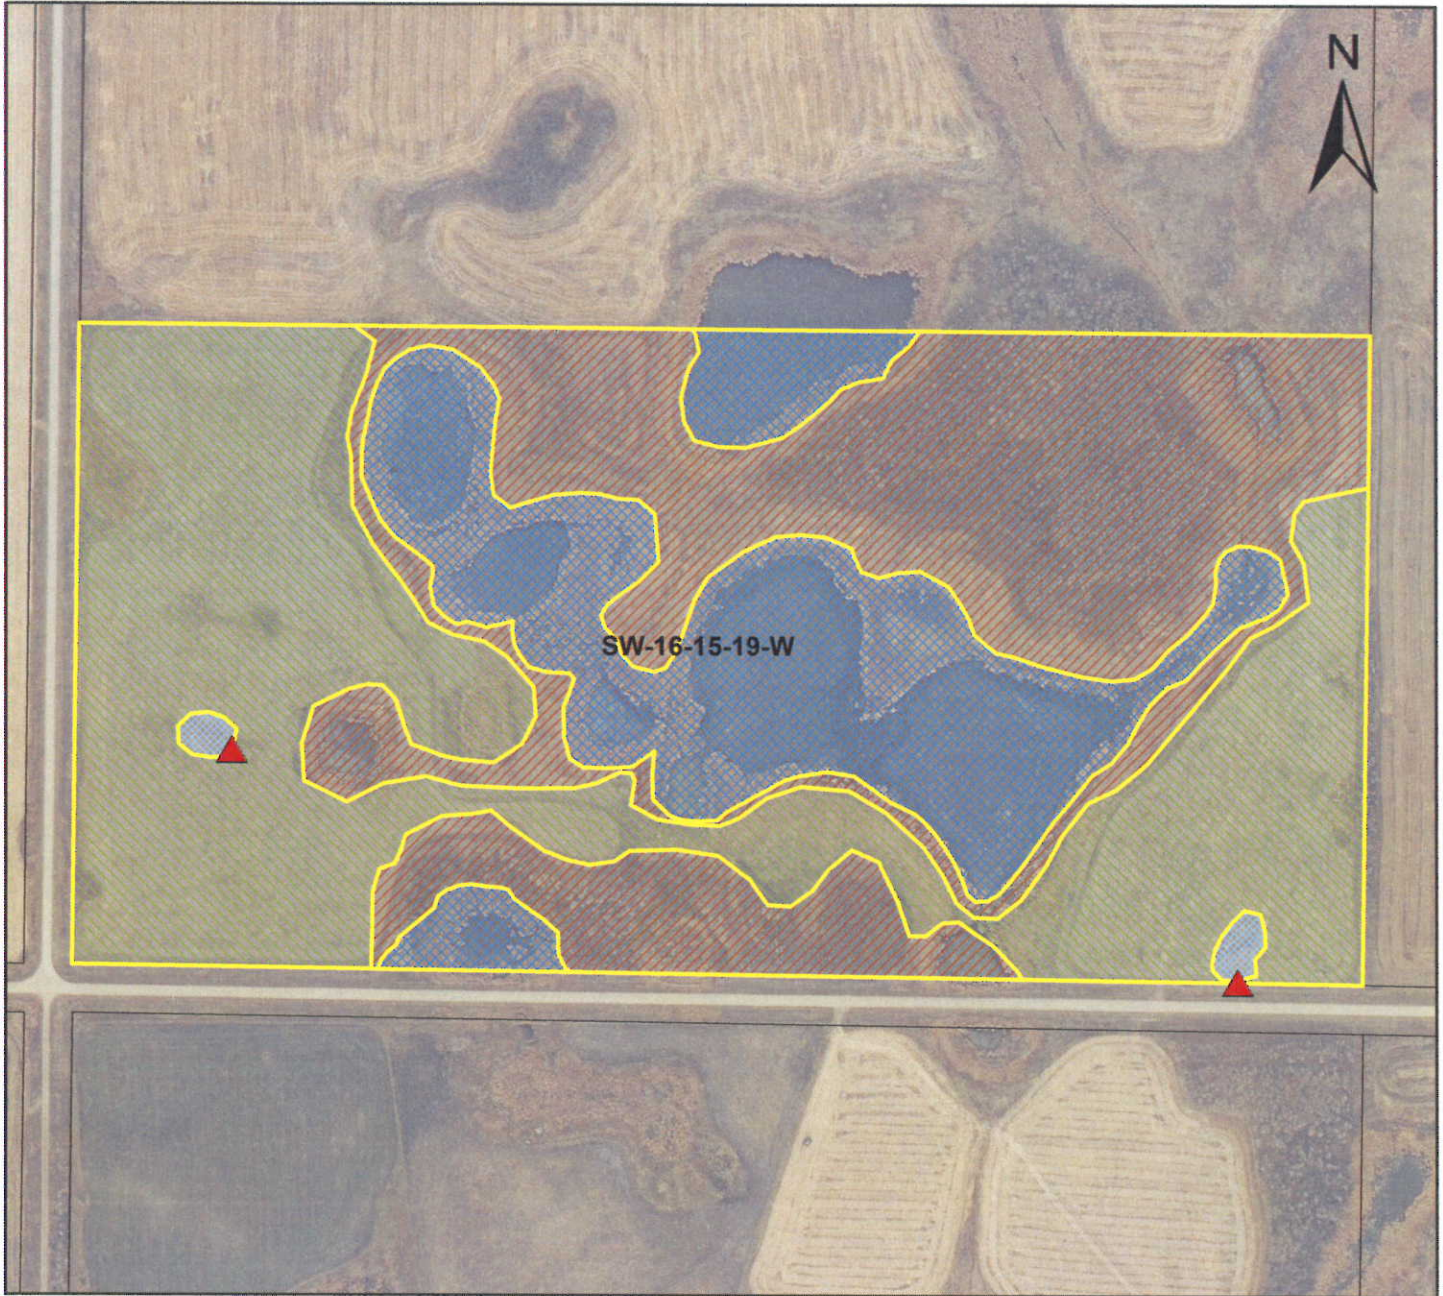

PJCT	SGMT	HAB_GOAL	AREA_AC
985	1	Upland Restoration	31.8
985	2	Upland Protection	28.7
985	3	Wetland Protection	19.0
985	4	Wetland Restoration	0.5

Legend

- Ditch Plugs
- Upland Protection
- Upland Restoration
- Wetland Protection
- Wetland Restoration

 Ducks Unlimited Canada Conserving Canada's Wetlands GIS SKETCH PLAN	Description: Wilton Ditch Plugs	Landscape: Min-Shoal	THIS SKETCH PLAN HAS BEEN CREATED FROM AIR PHOTO INTERPRETATION	
	Land Parcel: SW-16-15-19-W	Date: 03/23/2012 Drawn By: KG		
	NTS Map Sheet: [map_sheet]	Scale: 1:4,728	File: [file]	
	Photo Number: [photo_number]	Photo Date: [photo_date]	Page: 1	Checked By: [checked_by]